


KEY	BOTANICAL NAME	COMMON NAME	QUANTITY	SPACING	SIZE
AC. NER.	ACER PLATANUS	PLANE TREE MAPLE	5	AS SHOWN	1 1/2" x 1 1/2" CAL.
AC. PSE.	ACER PSEUDOPLANANUS	PLANES TREE MAPLE	8		1 1/2" x 1 1/2" CAL.
CAR. BET.	CARPINUS BETULUS	EUROPEAN HORNBEAM	1		2" x 10"
CAT. SAT.	CATALPA SATIVA	SUBTROPICAN CHESTNUT	1		1 1/2" x 1 1/2" CAL.
CAT. SPE.	CATALPA SPECIOSA	NORTHERN CATALPA	1		1 1/2" x 1 1/2" CAL.
CER. JAP.	CERCIDIPHYLLUM JAPONICUM	KATSURATREE	1		2" x 10"
COR. NUT.	CORNUS NUTTALLI	PACIFIC DOGWOOD	4		2" x 10"
DAV. INV.	DANIELA INNOVENSATA	DOYENEE	1		2" x 10"
FAG. SYL.	FRAXINUS SYLVATICA	EUROPEAN BEECH	1		2" x 10"
FEA. ALA.	FRANKLINIA ALATAMAHA	FRANKLINIA	1		2" x 10"
LIR. TUL.	LIRIODENDRON TULIPIFERA	AMERICAN MAGNOLIA	2		2" x 10"
LIG. STY.	LIQUIDAMBAR STRYACIFLUA	WEITCH KAGORUA	16		2" x 10"
LIR. TUL.	LIRIODENDRON TULIPIFERA	TULIPTREE	6		1 3/4" x 2 1/2" CAL.
P. JAP.	PERSEA JAPONICA	CORNBAN LINDON	6		1 3/4" x 2 1/2" CAL.
PER. JAP.	PERSEA JAPONICA	YOSHINO CHERRY	6		2" x 10"
QUE. NER.	QUERCUS NORTONII	NORTHERN RED OAK	2		1 3/4" x 2 1/2" CAL.
QUE. ROB.	QUERCUS ROBUR	ENGLISH OAK	10		1 3/4" x 2 1/2" CAL.
ZEL. SER.	ZELKOVA SERATA	JAPANESE ZELKOVA	18		1 3/4" x 2 1/2" CAL.

SHRUB AND GROUND COVER LIST				
KEY	BOTANICAL NAME	COMMON NAME	QUANTITY	SPACING
AZA. PON.	AZALEA PONCINII	PONCIN AZALEA	18	18" x 18"
BEG. NY.	BEGONIA NYCTAGINIFOLIA	BEGONIA NY.	100	30" x 30"
IL. CRE.	ILEX CREMATA CONIFOLIA	JAPANESE HOLLY	100	30" x 30"
PIER. JAP.	PIERIS JAPONICA	ANDROMEDA	2	AS SHOWN
RHO. PIR.	RHOIS PIRARACENSIS	RHOIS	2	AS SHOWN
SOR. NY.	SORBUS NYCTAGINIFOLIA	JAPANESE DOGWOOD	10	30" x 30"

NOTE: FOR THIS WORK, COM. X. 11. IS CONSIDERED TO BE A SHRUB

IRRIGATION LEGEND	
○	FULL CIRCLE SPRAY HEAD BUCKNER NO. 405 HO
○	WALL NO. 405 HO
○	QUARTER NO. 405 HO
○	140° NO. 403 - O
○	140° NO. 403 - O
○	BUBBLER HEAD NO. 402
○	HAIR CIRCLE SHRUB HEAD NO. 403 HU
○	STRIP SHRUB HEAD BAINBRIDGE NO. 161 ST
○	QUICK COUPLING VALVE NO. 14
○	MANUAL ANGLE CONTROL VALVE OF SIZE SHOWN
○	ELECTRIC CONTROL VALVE OF SIZE SHOWN
○	MANUAL DRAIN VALVE
○	AUTOMATIC DRAIN VALVE 1/2" BUCKNER NO. 66A


○	STRIP SHRUB HEAD BAINBRIDGE NO. 161 ST
○	RANDOLPH MAT NO. 304 H
—	GALVANIZED IRON MAIN LINE
—	DISTRIBUTION LINE
—	PIPELINES NOT CONNECTED
—	ELECTRICAL WIRES FROM CONTROLLER TO VALVES

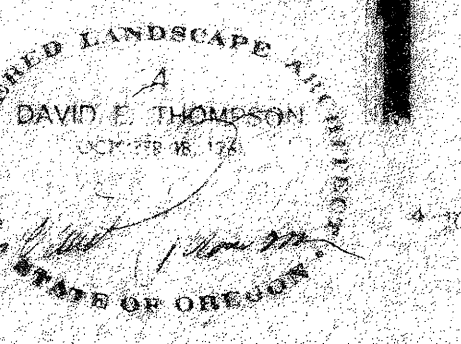

LAWRENCE HALPRIN & ASSOCIATES LANDSCAPE ARCHITECTS
 1420 MONTGOMERY STREET SAN FRANCISCO 11, CALIFORNIA YUKON 8-6110
DAVID E. THOMPSON RESIDENT LANDSCAPE ARCHITECT
 314 DAVIS BUILDING PORTLAND, OREGON 97204 2/23-2585

SOUTH AUDITORIUM
 PORTLAND DEVELOPMENT COMMISSION PORTLAND, OREGON

SCHEDULE II NORTH PARK
 IRRIGATION & PLANTING PLAN
 SHEET NO. 15 OF 38 SHEETS
 DRAWN BY: CHECKED BY: FOR NO. SCALE: DATE:

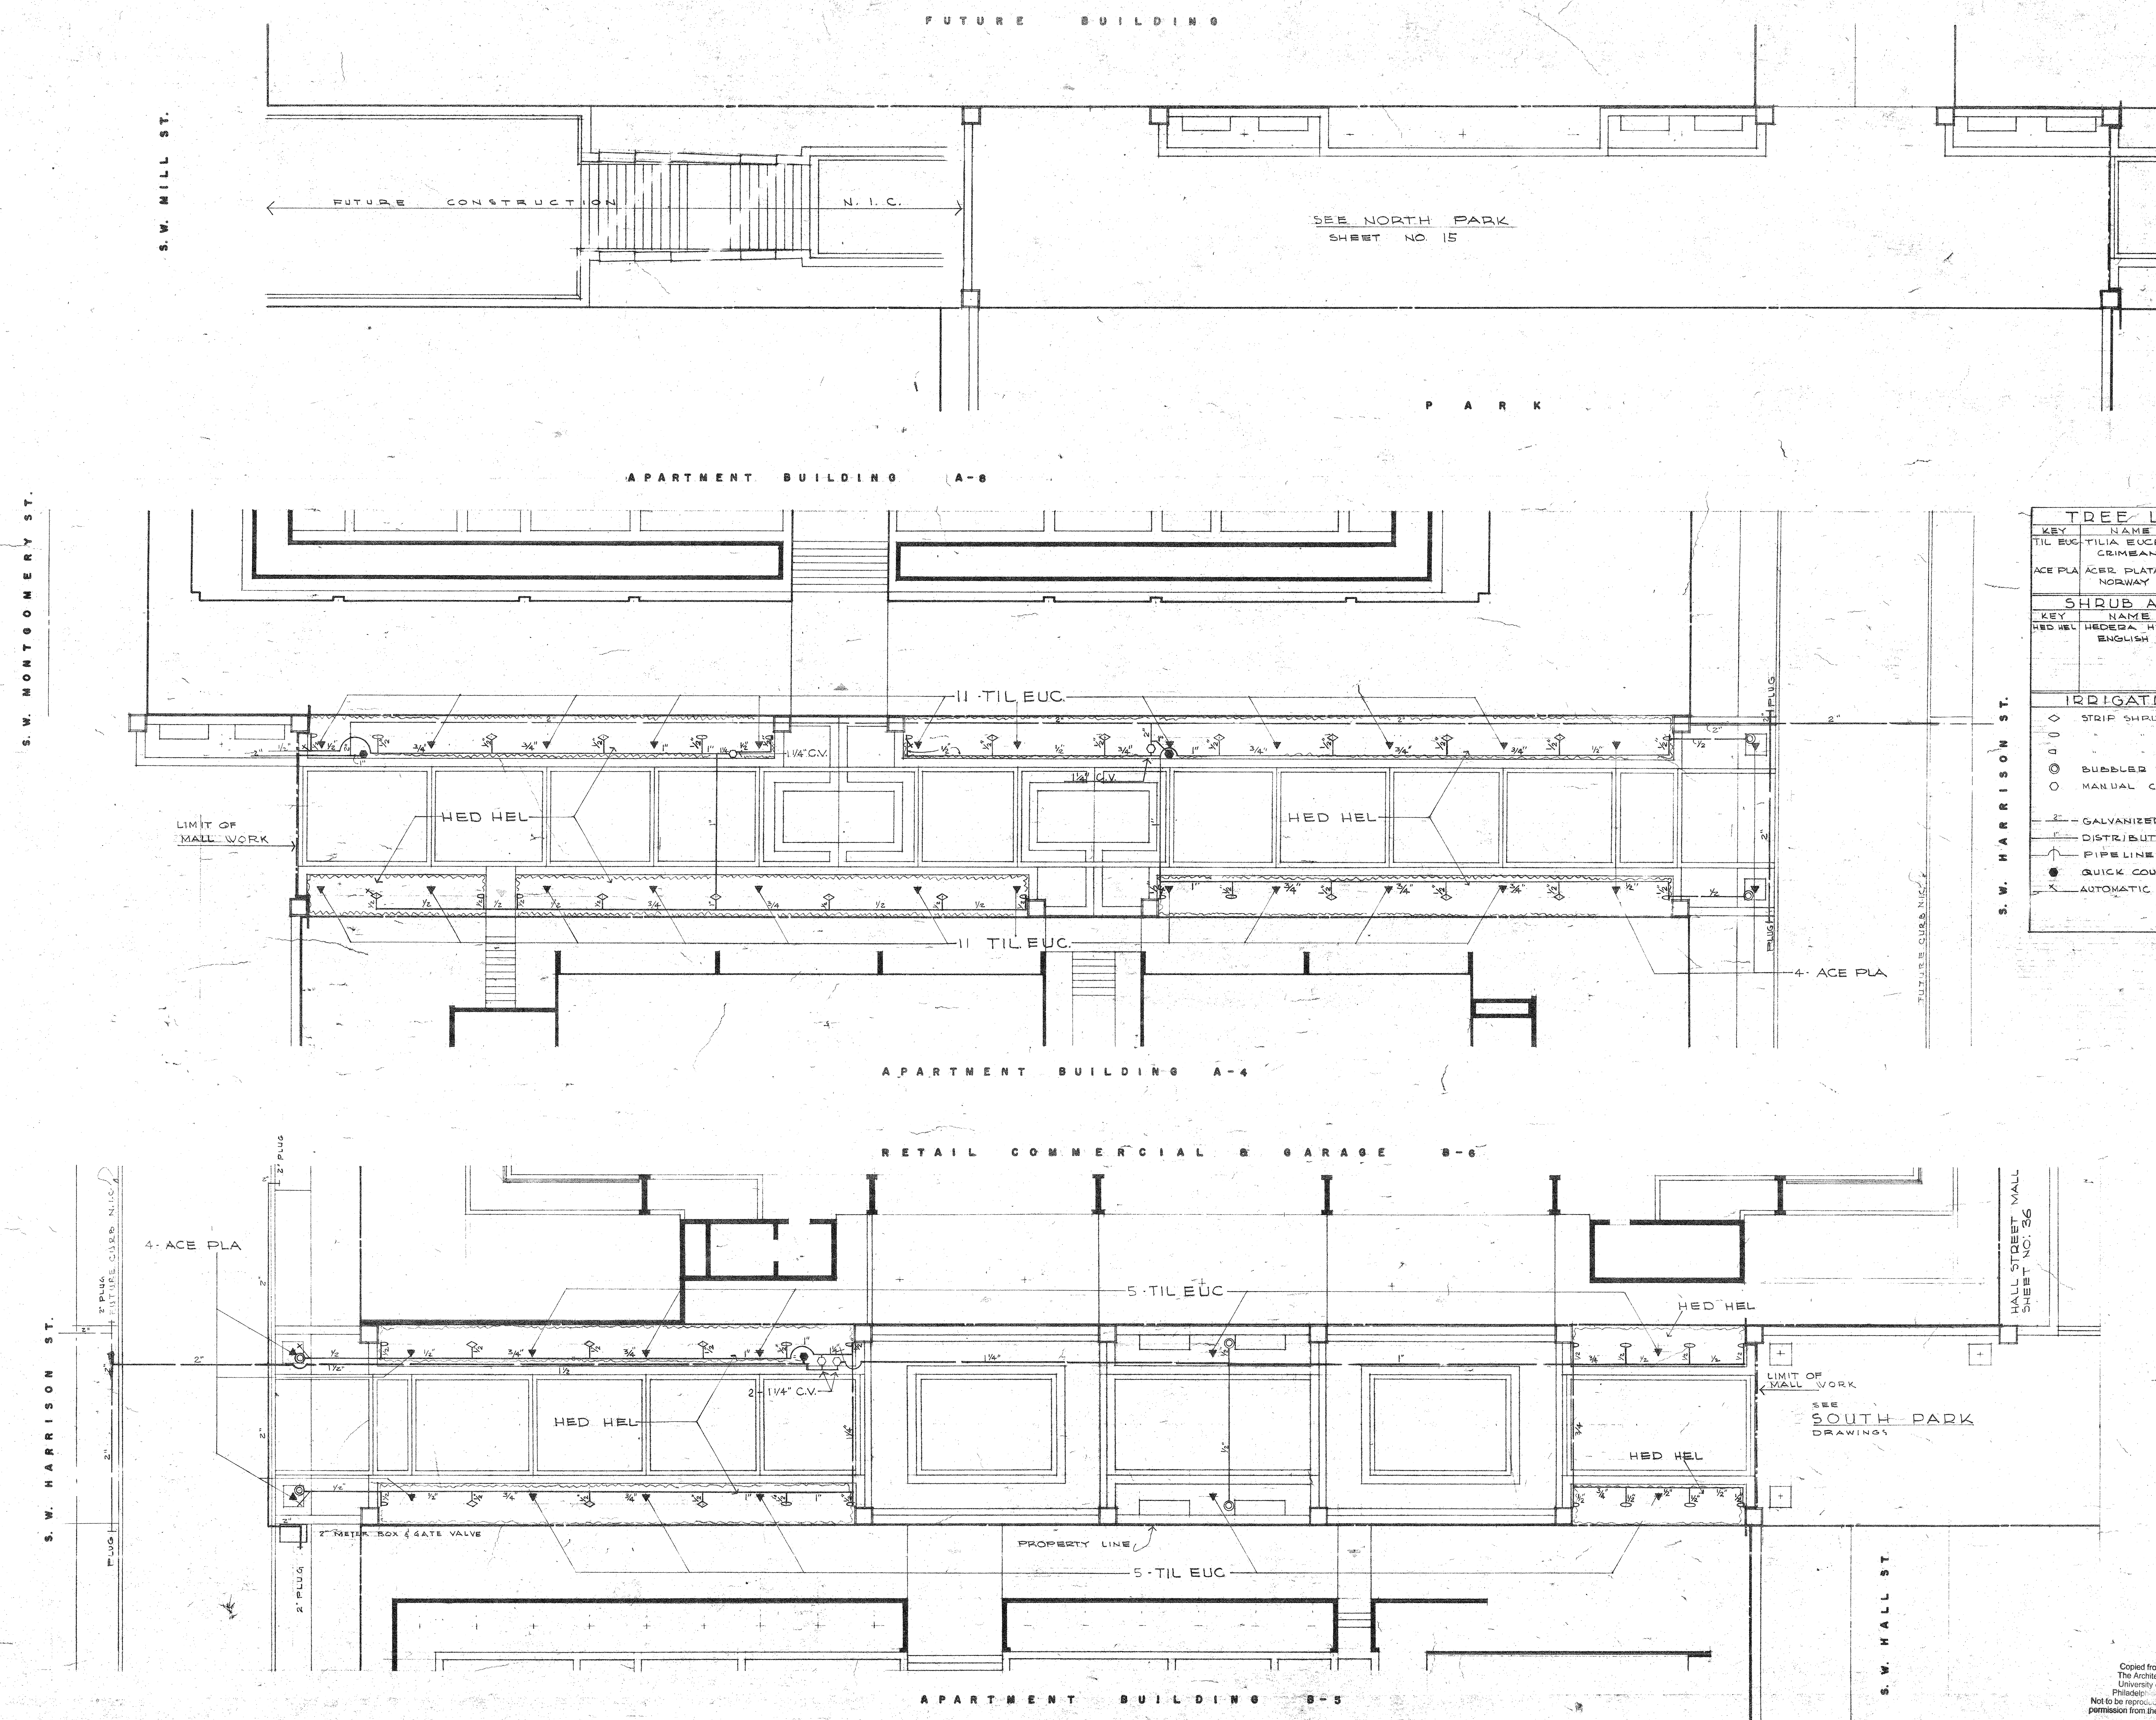

TREE LIST				
KEY	NAME	QUANTITY	SPACING	SIZE
TIL EUC	TILIA EUCHLORA	32	AS SHOWN	1 1/4" - 2" CAL.
ACE PLA	ACE PLATANOIDES NORWAY MAPLE	8		1 1/4" - 2" CAL.

SHRUB AND GROUND COVER LIST				
KEY	NAME	QUANTITY	SPACING	SIZE
HED HEL	HEDERA HELIX ENGLISH IVY	TO COVER	18" x 6"	2 1/4" FOTS

IRRIGATION LEGEND				
◇	STRIP SHRUB HEAD, RAINBIRD NO. 161 ST.			
○	BUBBLER SHRUB HEAD, BUCKNER NO. 102			
○	MANUAL CONTROL VALVE (C.V.)			
—	GALVANIZED IRON MAIN LINE			
—	DISTRIBUTION LINE			
—	PIPE LINES NOT CONNECTED			
●	QUICK COUPLING VALVE, BUCKNER NO. 14			
X	AUTOMATIC DRAIN VALVES, NO. 26A			

Copied from an original in
 The Architectural Archives,
 University of Pennsylvania
 Philadelphia, PA 19104-6311
 Not to be reproduced or published without
 permission from the Architectural Archives.

LAWRENCE HALPRIN & ASSOCIATES LANDSCAPE ARCHITECTS
 1620 MONTGOMERY STREET SAN FRANCISCO 11, CALIFORNIA YUKON 6-6110
DAVID E. THOMPSON RESIDENT LANDSCAPE ARCHITECT
 318 DAVIS BUILDING PORTLAND, OREGON 97204 228-2665

SOUTH AUDITORIUM
 APPROVED BY

 PORTLAND DEVELOPMENT COMMISSION PORTLAND, OREGON

SCHEDULE III
SECOND AVENUE MALL
PLANTING & IRRIGATION PLAN

SHEET NO. **34**
 OF 38 SHEETS

REVISIONS: REVISED AS BUILT 11.3.66
 DRAWN BY: DAB
 CHECKED BY: D.E.T.
 JOB NO: L4-6523
 DATE: 2-22-65
 SCALE: 1/8" = 1'-0"